

H
G
F
E
D
C
B
A

8

7

6


5

4

3

2

1

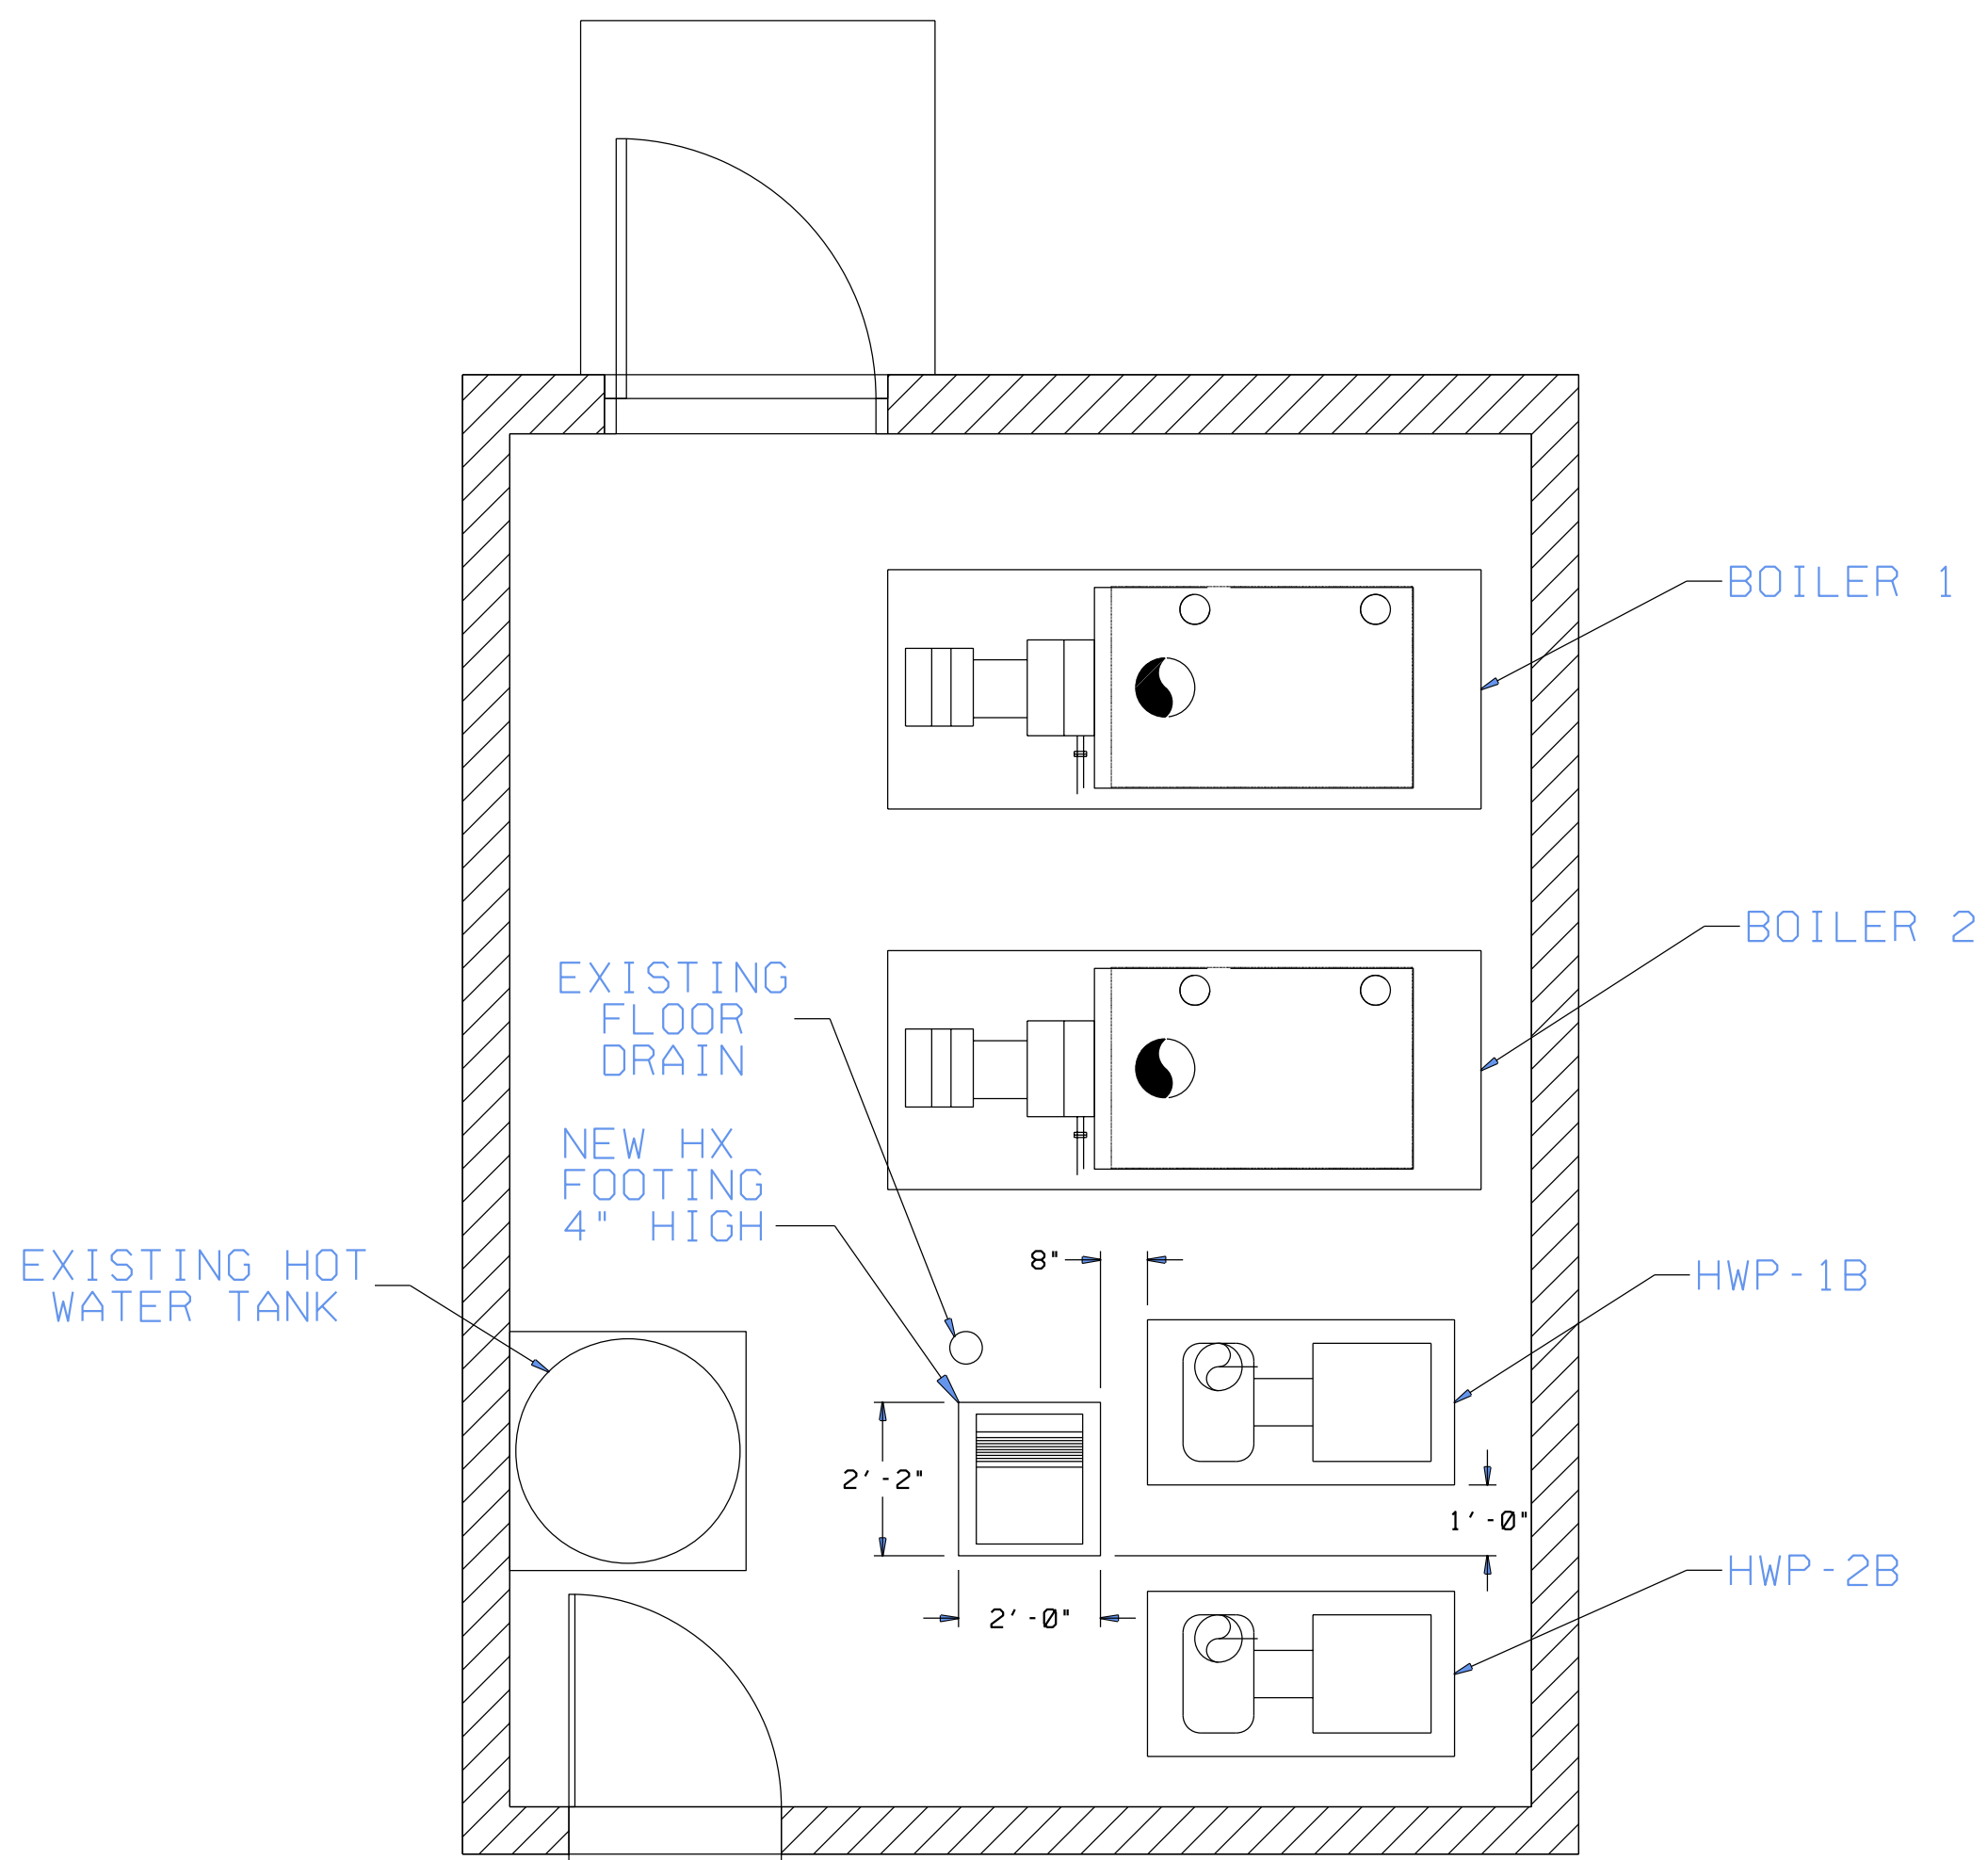

BOILER ROOM
PLAN

FOR OFFICIAL USE ONLY
PUBLIC AVAILABILITY TO BE DETERMINED UNDER 5 USC 552

REV	APPROVED DATE	DESCRIPTION	JCN	REDLINE DATE	APVD
DEPARTMENT OF TRANSPORTATION FEDERAL AVIATION ADMINISTRATION NORTHWEST MOUNTAIN REGION ATCT MODIFIED BOILER ROOM LAYOUT PLAN BILLINGS BILLINGS LOGAN INTERNATIONAL AIRPORT MT					
PROJECT ENGINEER		ISSUED BY			
JONATHAN C. SALTER		RAYMOND N. LAWRENCE			
DESIGNED		DATE		JCN	
DRAWN		AIRWAY FACILITIES		DRAWING NO	
CHECKED		ANM-400		BIL-D-ATCT-A---	

ISSUED FOR PROJECT RECORD DRAWING

LAST MODIFIED
3/29/2011 1:40:36 PM QUEST

8

7

6

5

4

3

2

1

DRAWING PRODUCED ON ANM REGION MICROSTATION SYSTEM

APPROVAL